







1
A-10
HOME FLOOR PLAN
1/4"=1'-0"

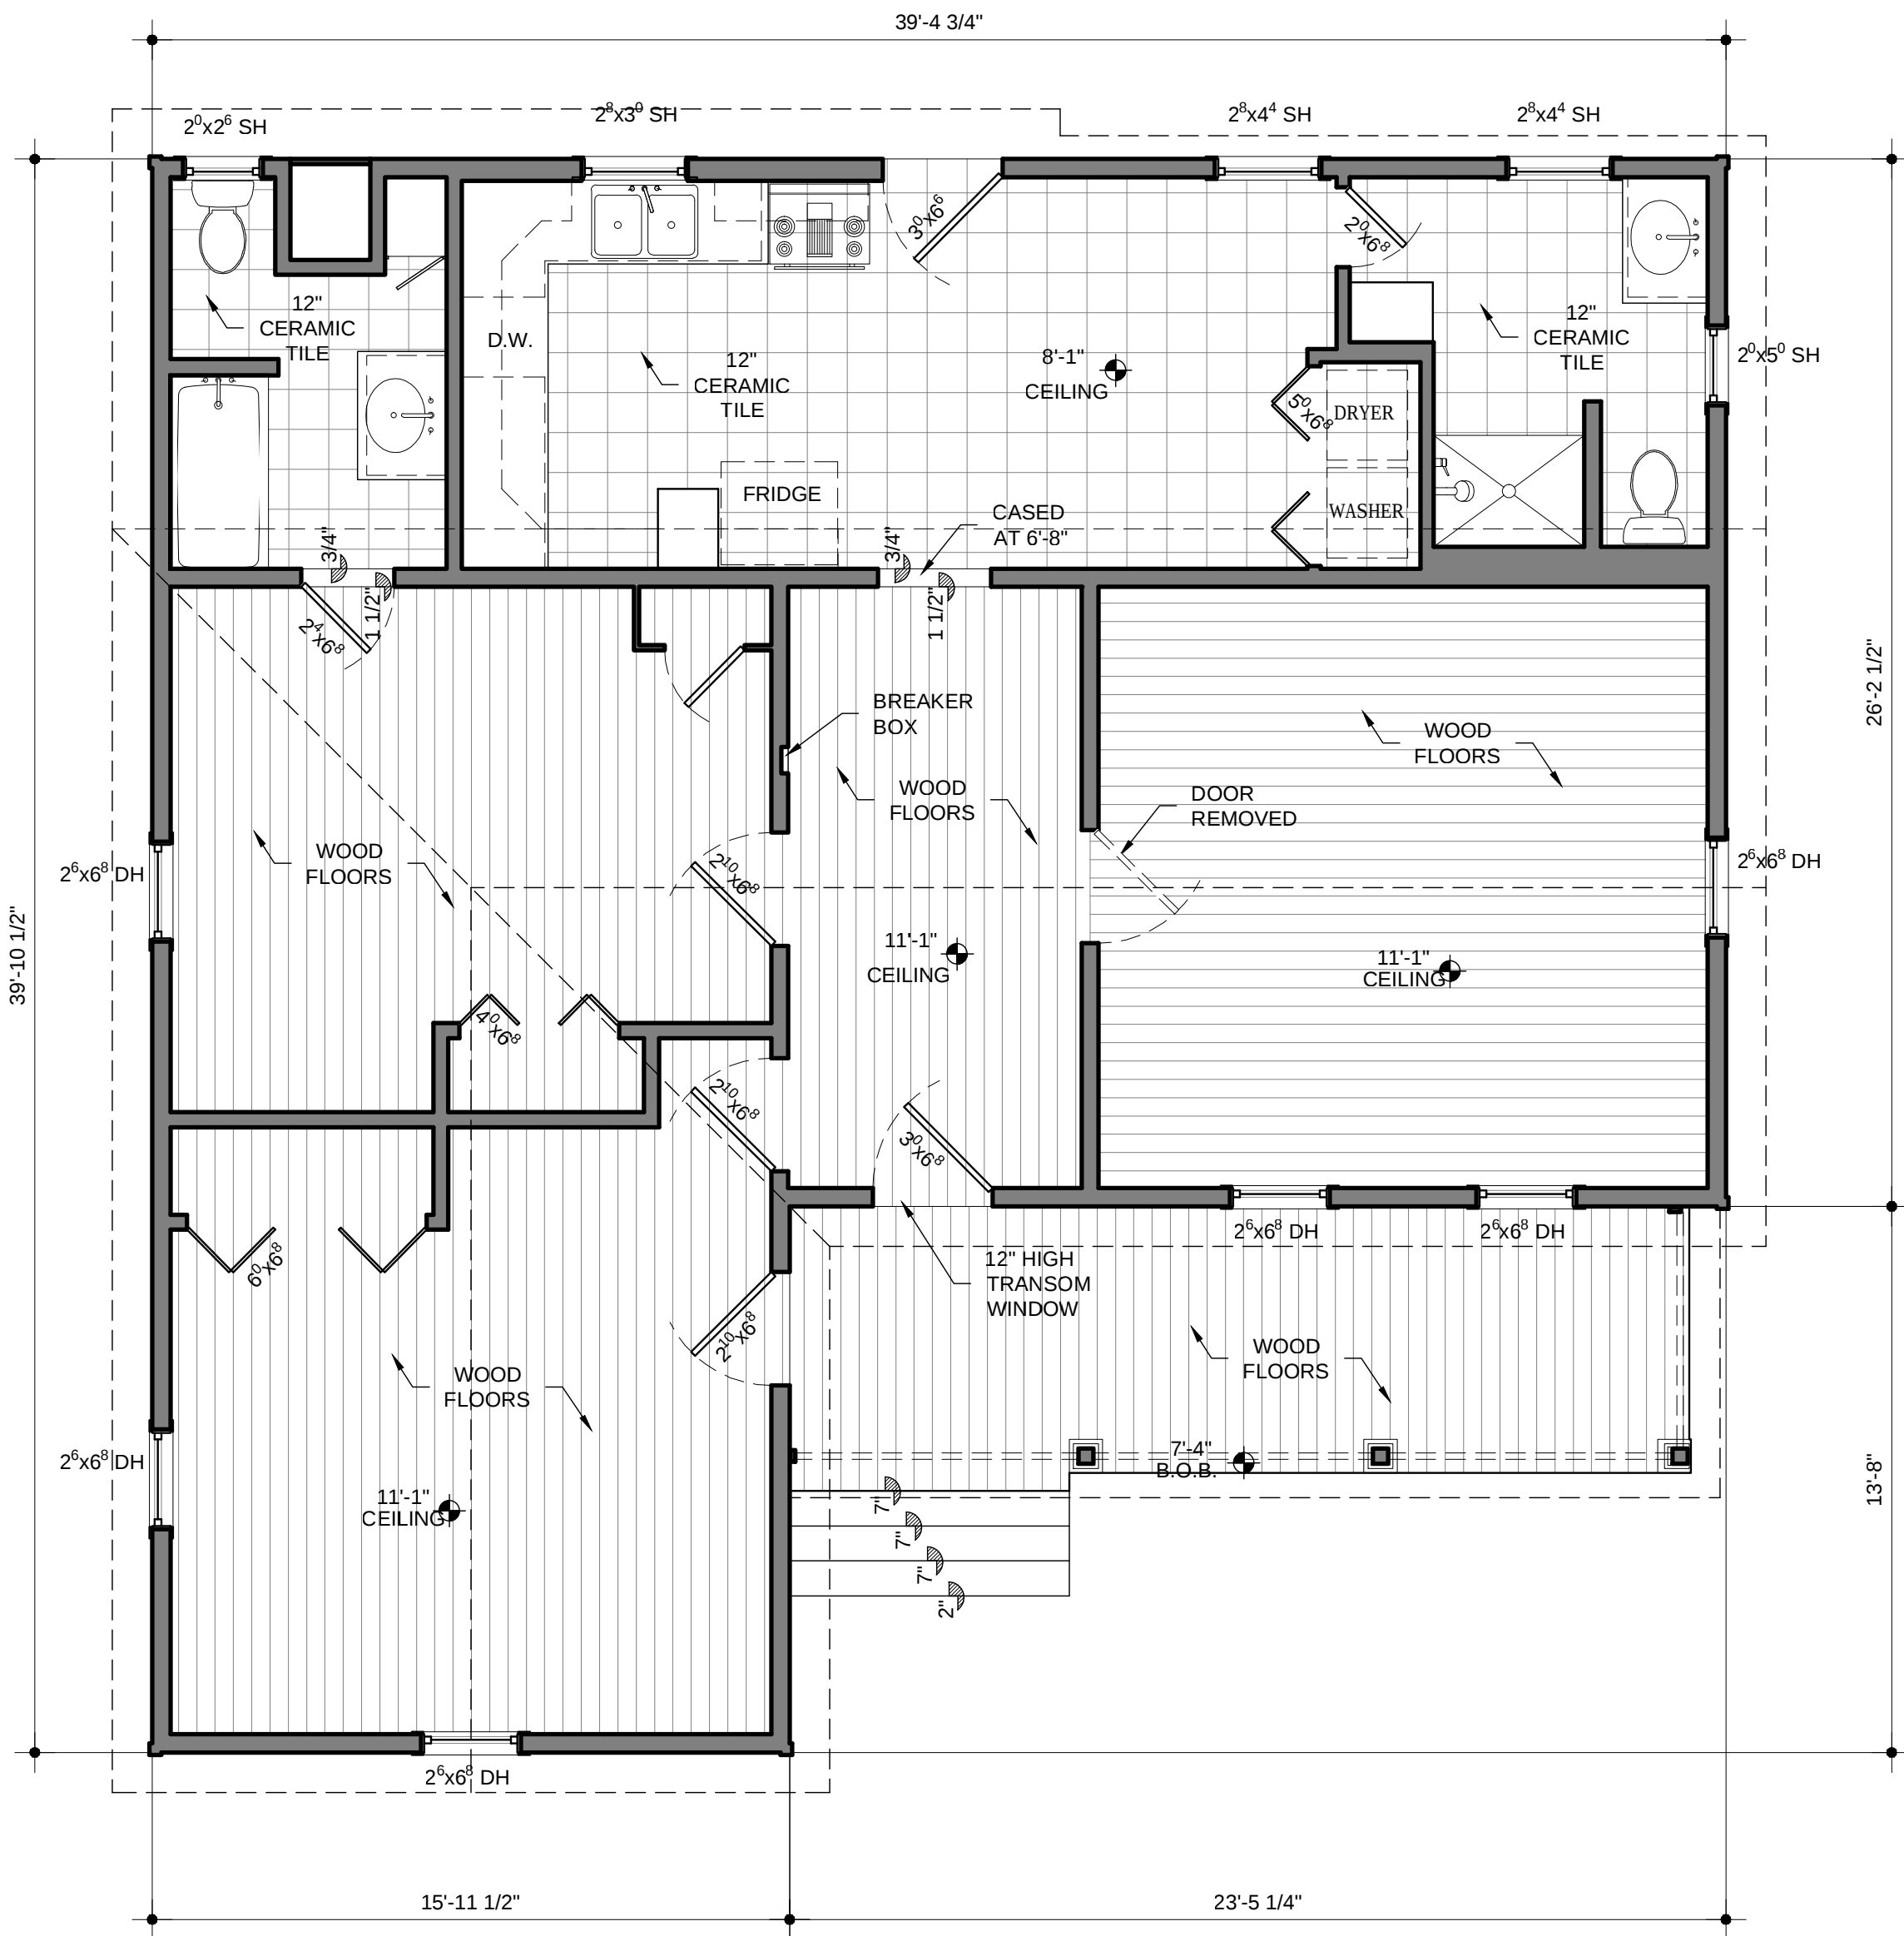

SQUARE FOOTAGE		
MAIN HOME		
CONDITIONED	1,251	SF
FRONT PORCH	145	SF
GARAGE		
CONDITIONED	495	SF
TOTAL OF ALL SPACES	1,891	SF

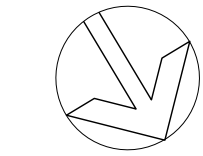

2
A-10
GARAGE FLOOR PLAN
1/4"=1'-0"

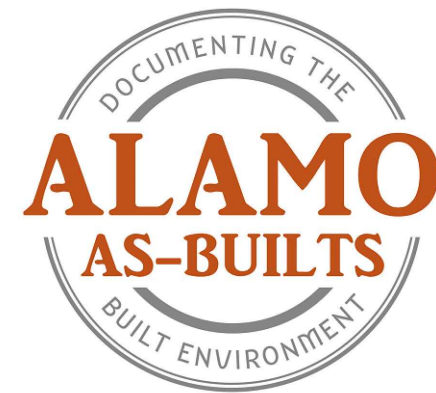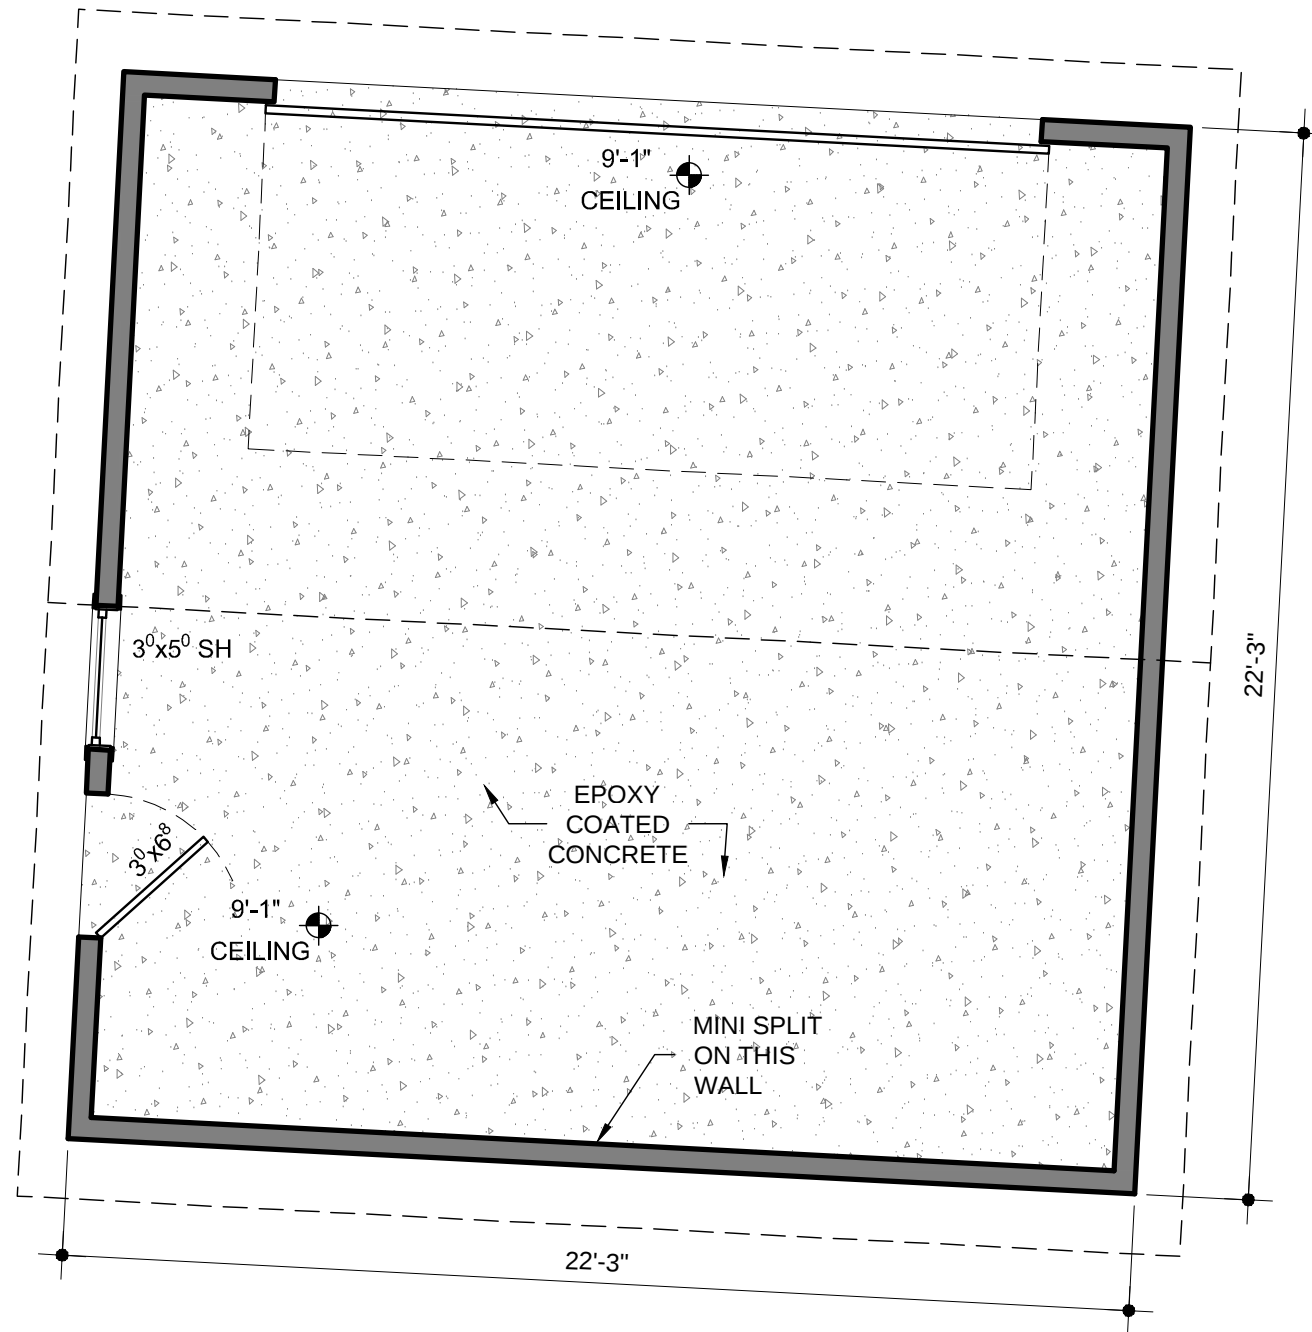

JODY BAKER 210.705.4101
jody@alamoasbuilt.com AlamoAsBuilt.com

574 S. ACADEMY AVE.
NEW BRAUNFELS, TX


FLOOR PLANS

DATE: 07. 05. 22


AS-BUILTS

Sheet Number
A-10


NORTH

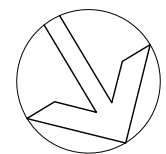


1
A-11 HOME ROOF PLAN
1/4"=1'-0"

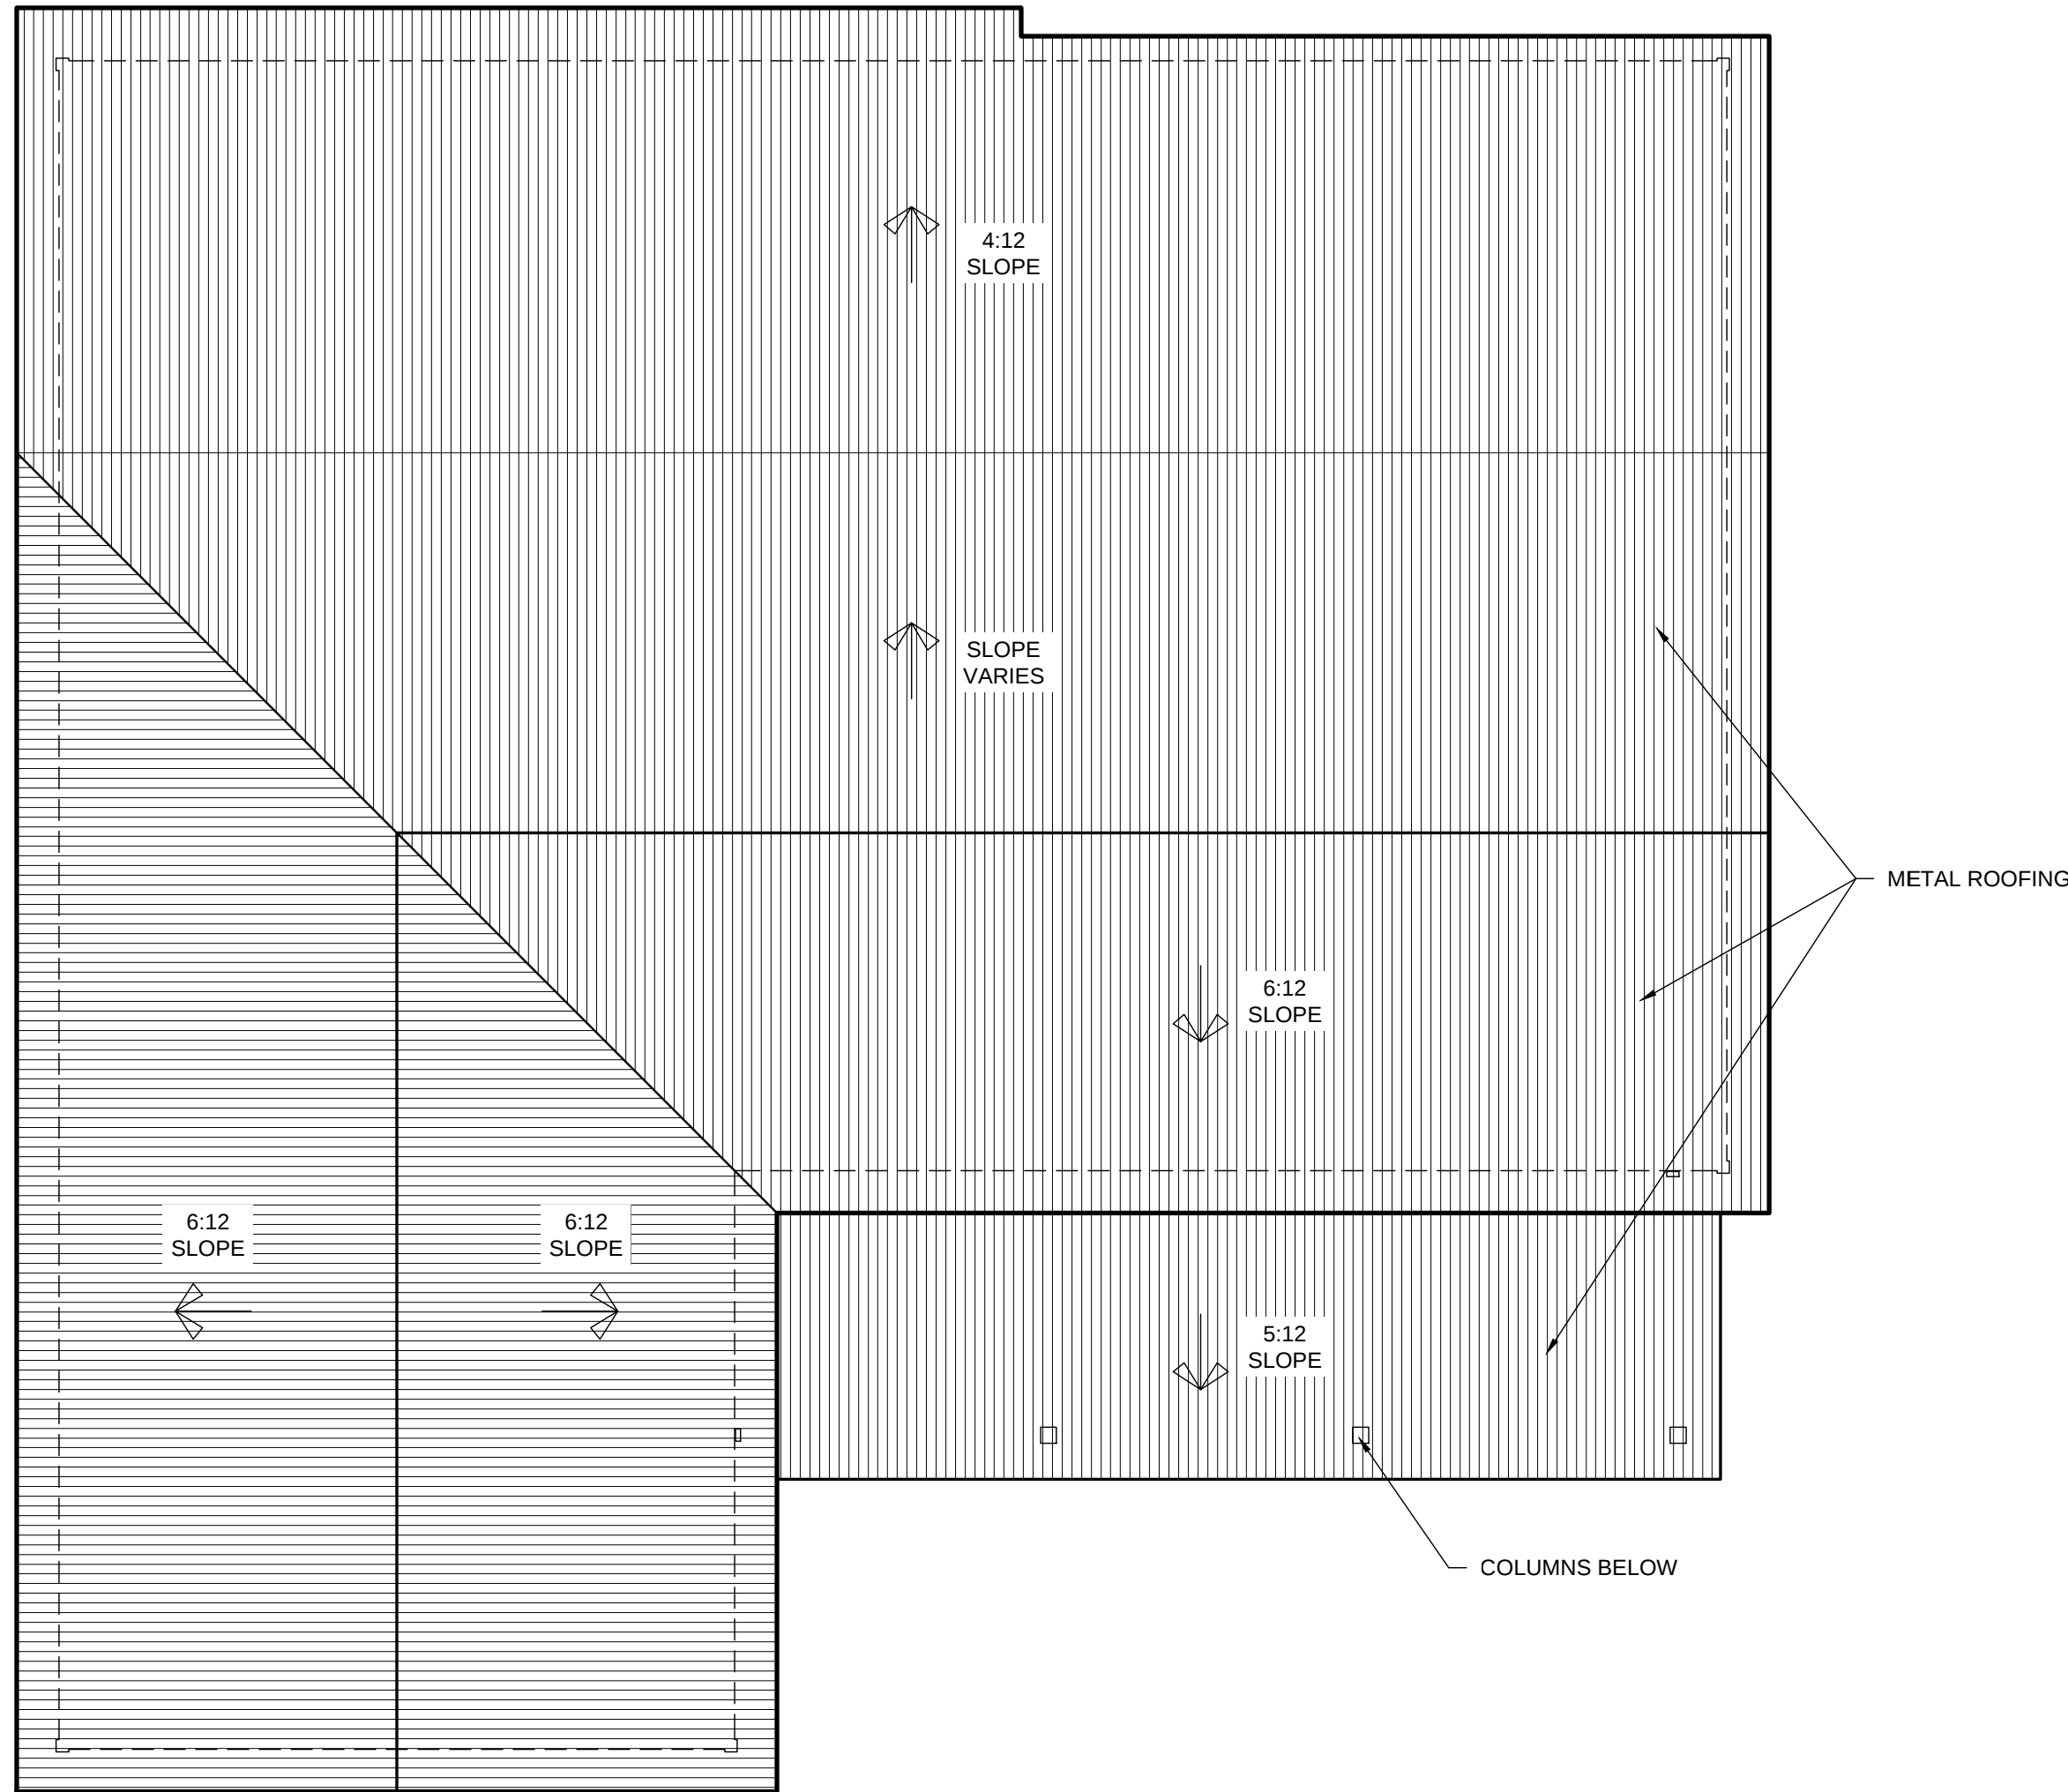

NORTH

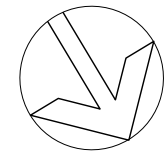

2
A-11 GARAGE ROOF PLAN
1/4"=1'-0"

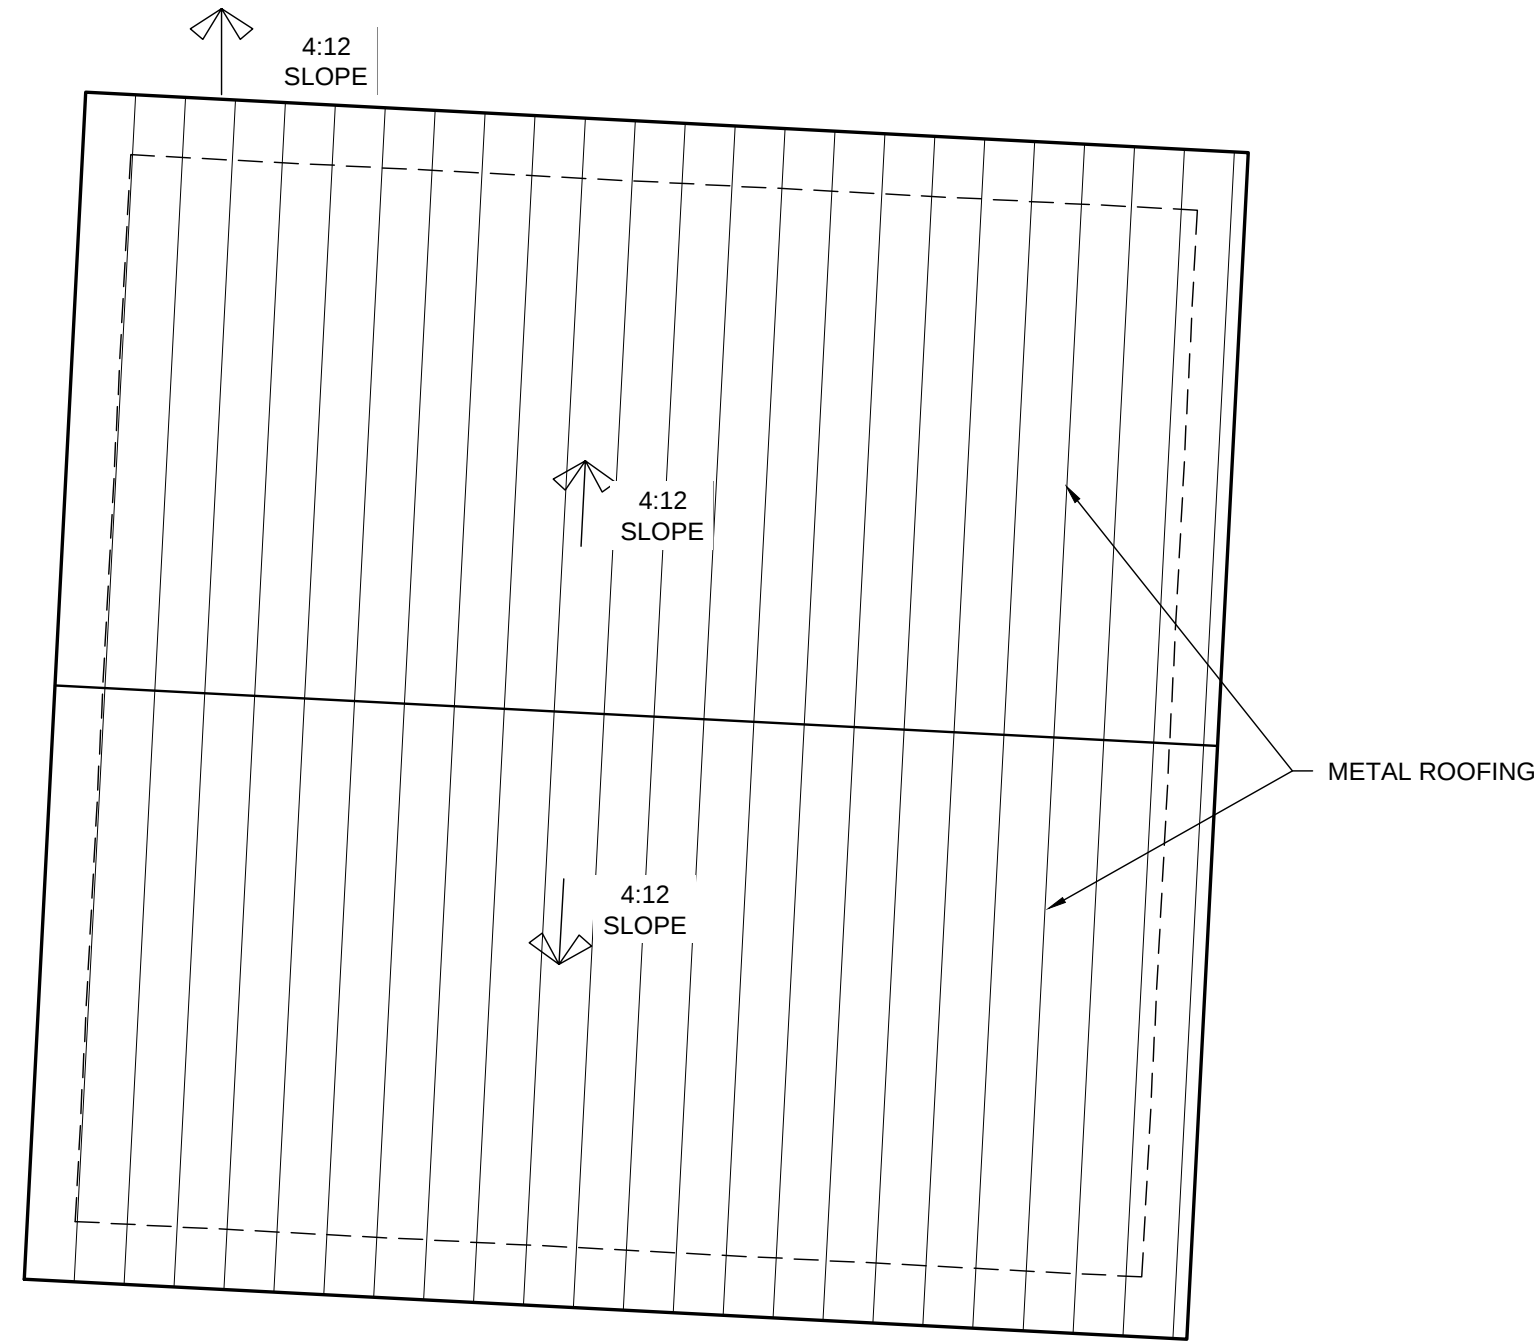

JODY BAKER 210.705.4101
jody@alamoasbuilds.com AlamoAsBuilds.com

574 S. ACADEMY AVE.
NEW BRAUNFELS, TX


ROOF PLANS

DATE: 07. 05. 22


AS-BUILTS

Sheet Number


A-11

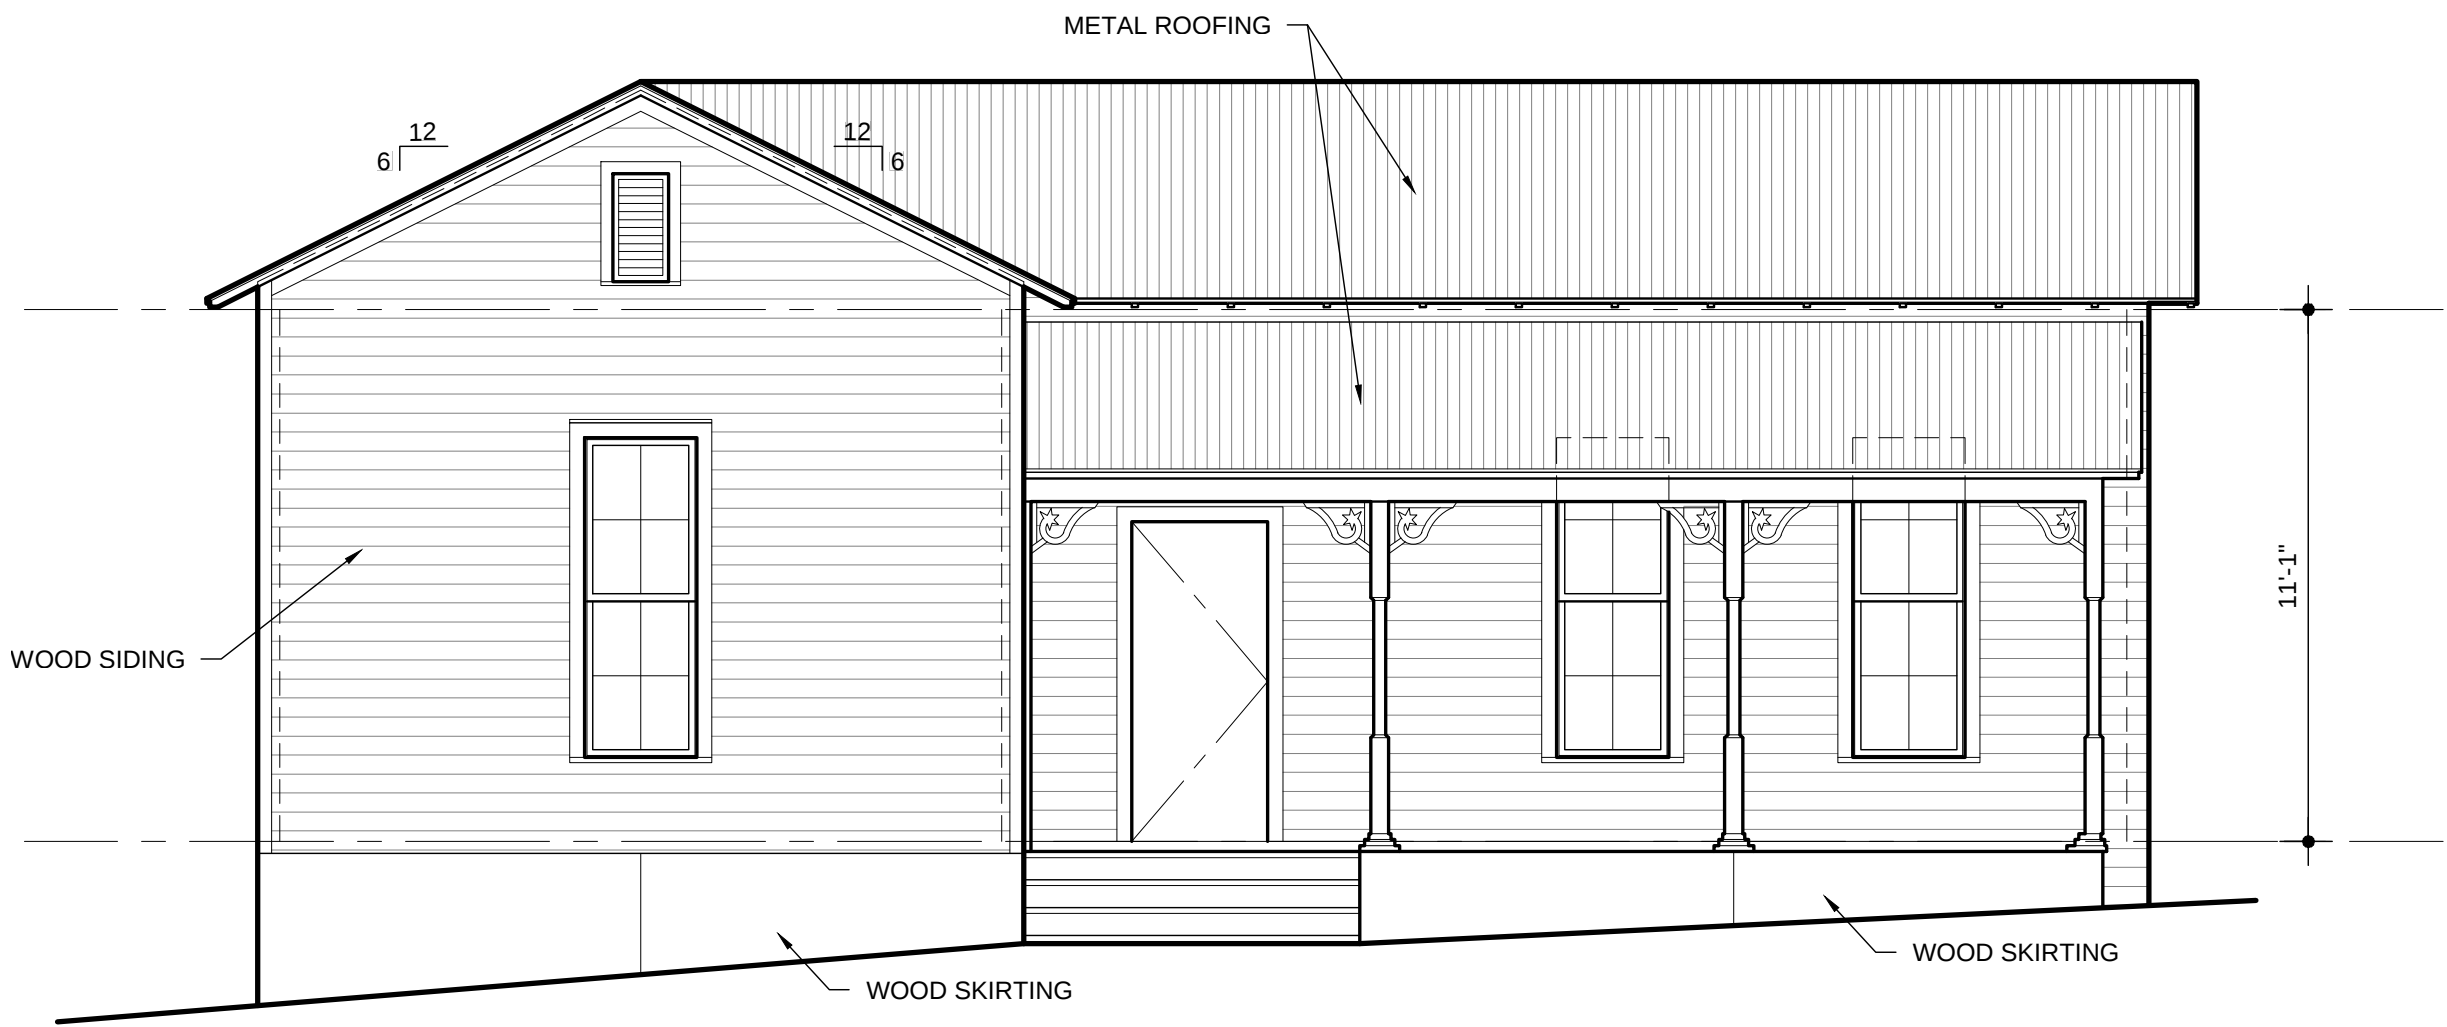


1 FRONT ELEVATION
A-20 1/4"=1'-0"

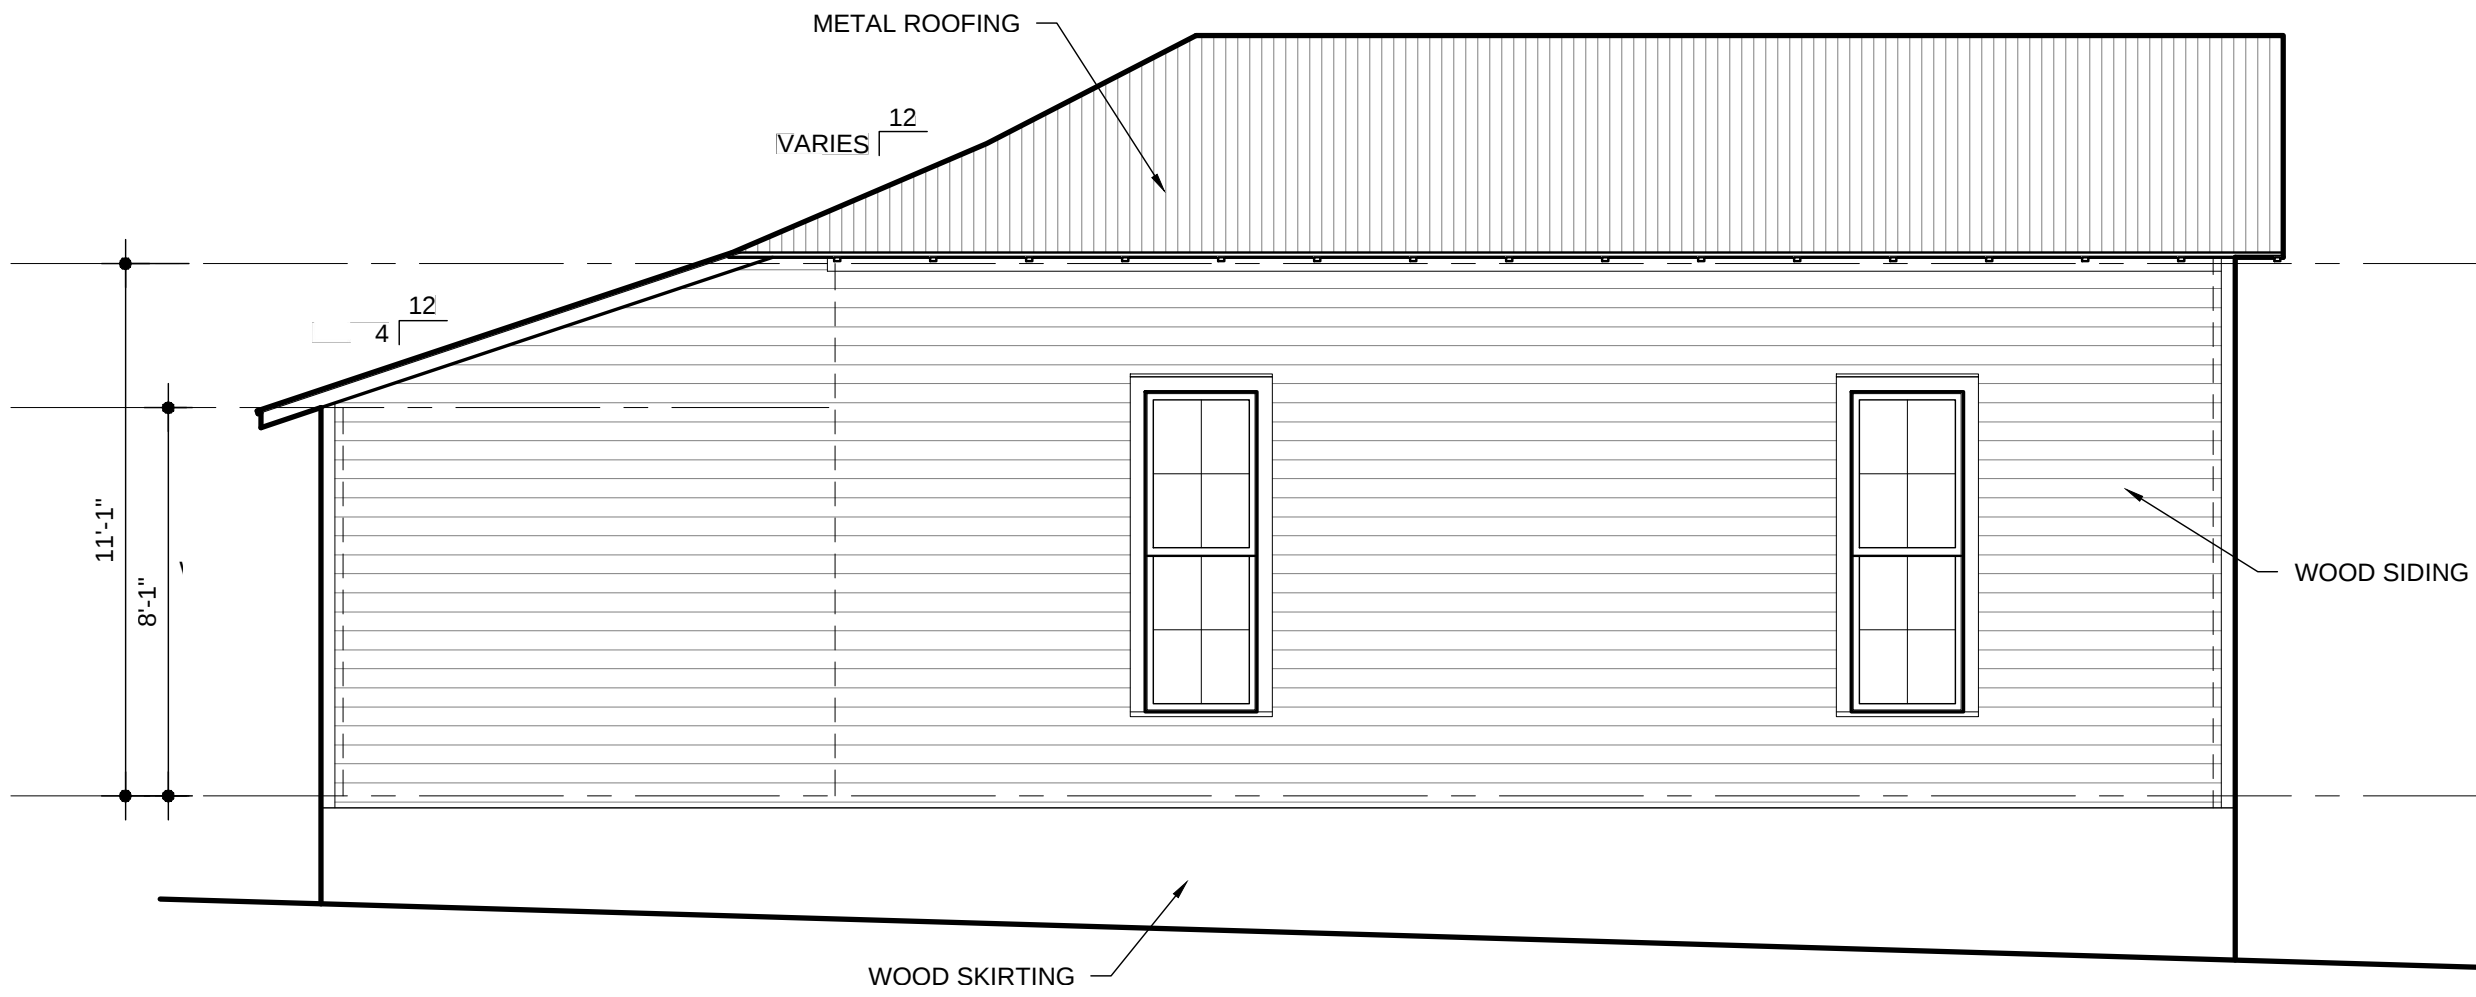


2 LEFT ELEVATION
A-20 1/4"=1'-0"

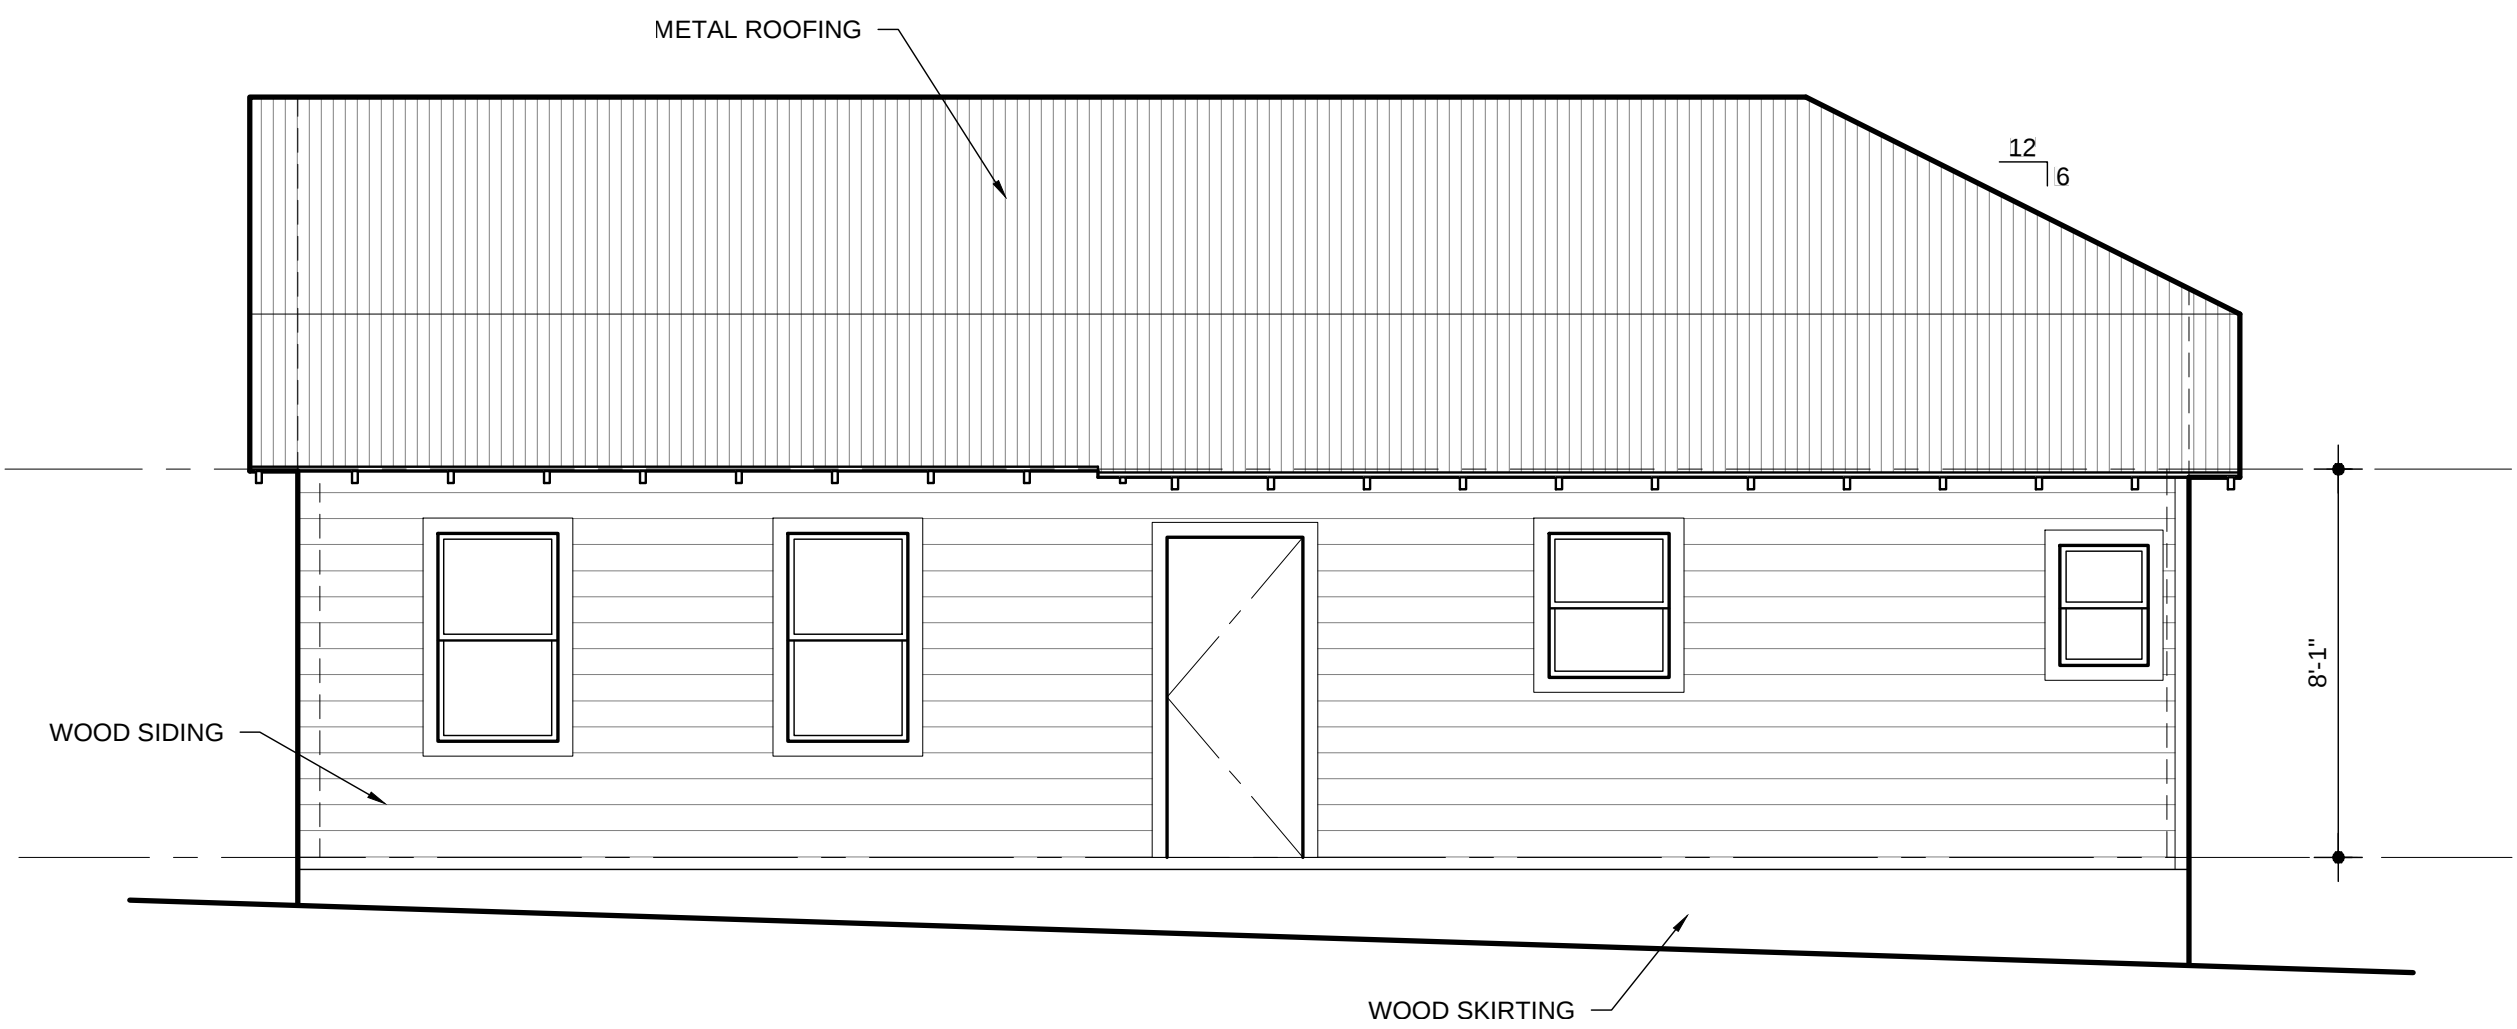


3 REAR ELEVATION
A-20 1/4"=1'-0"

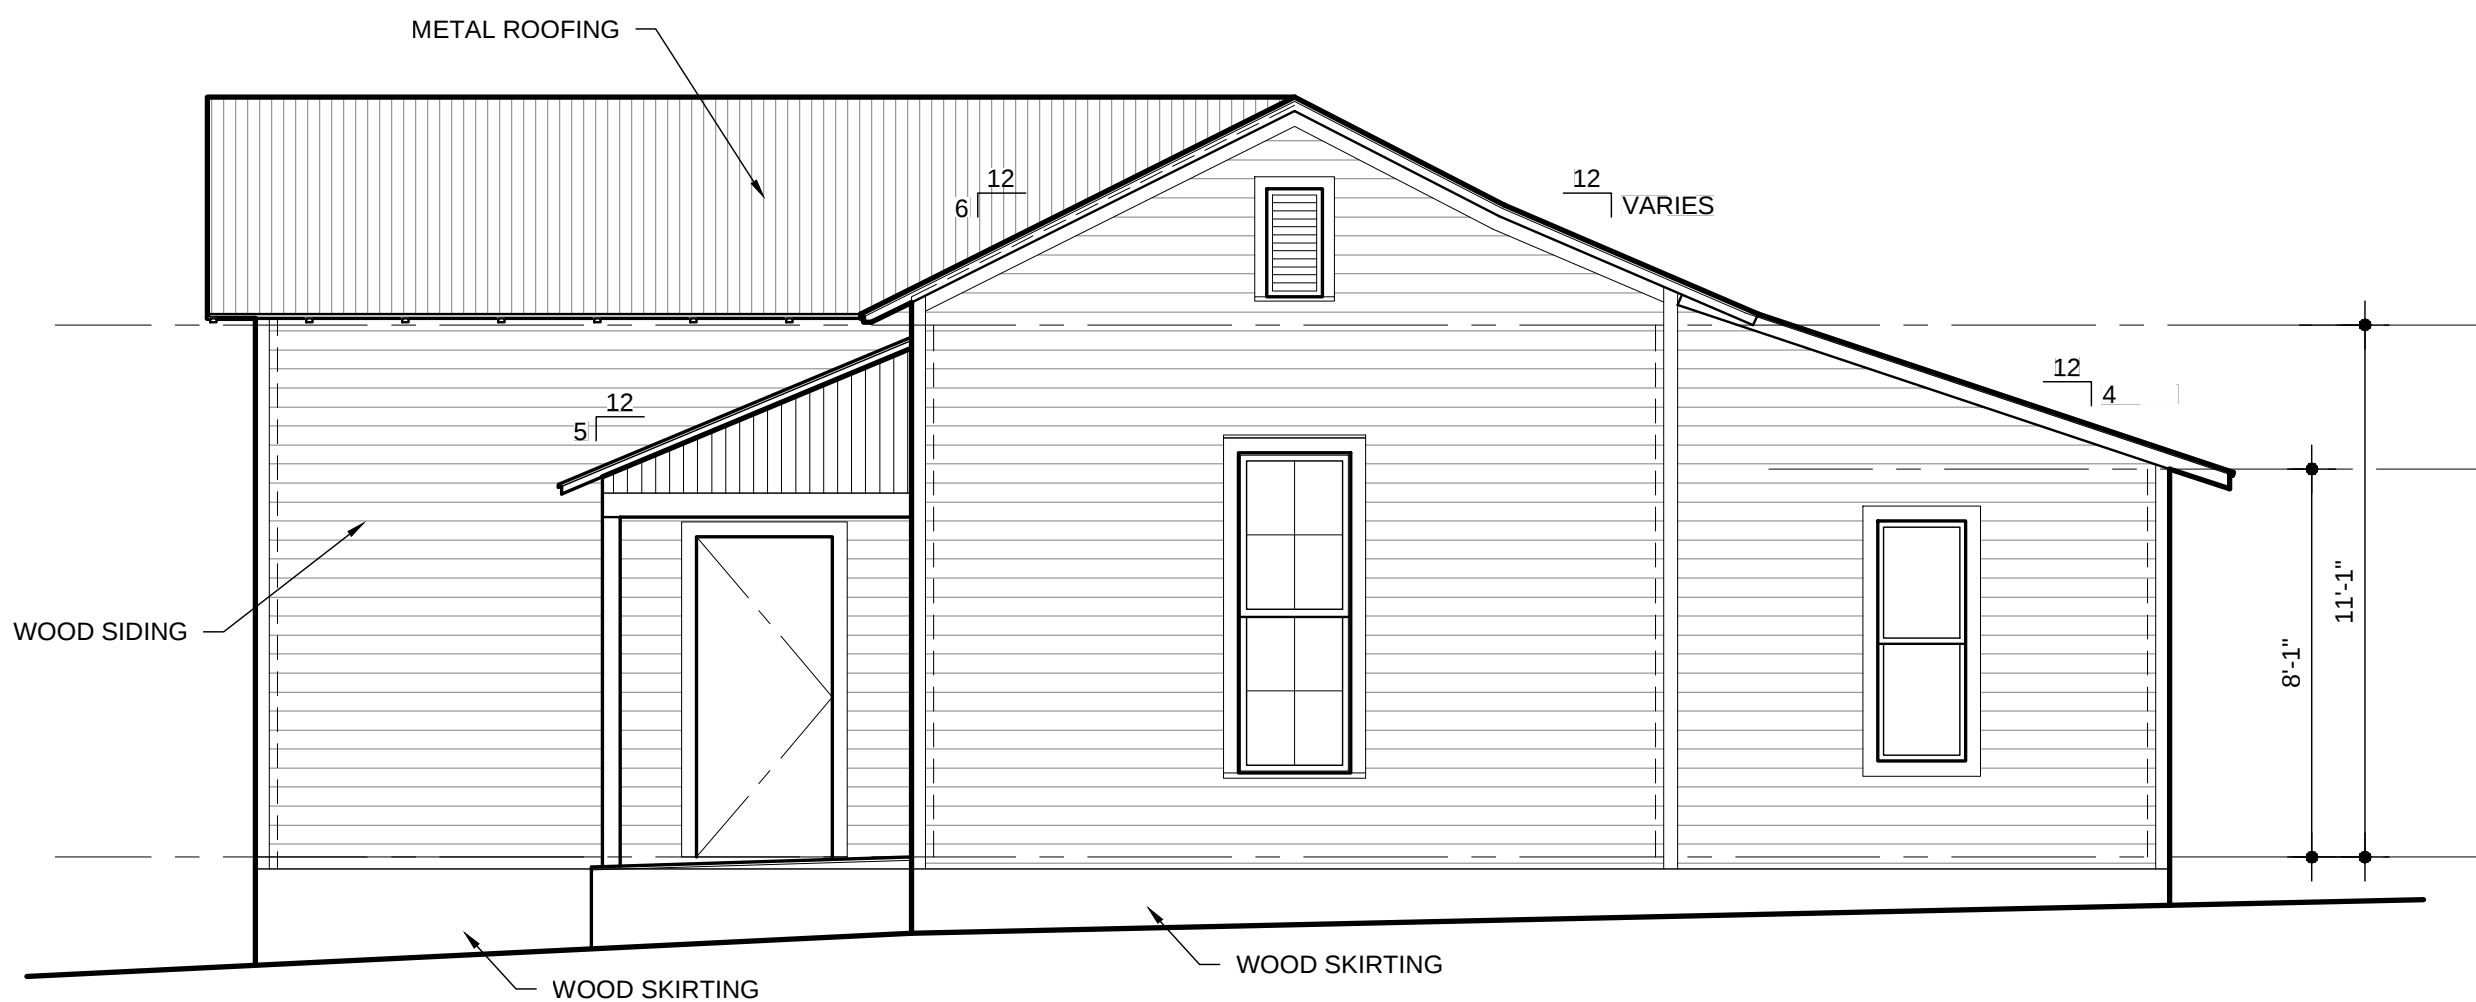


4 RIGHT ELEVATION
A-20 1/4"=1'-0"

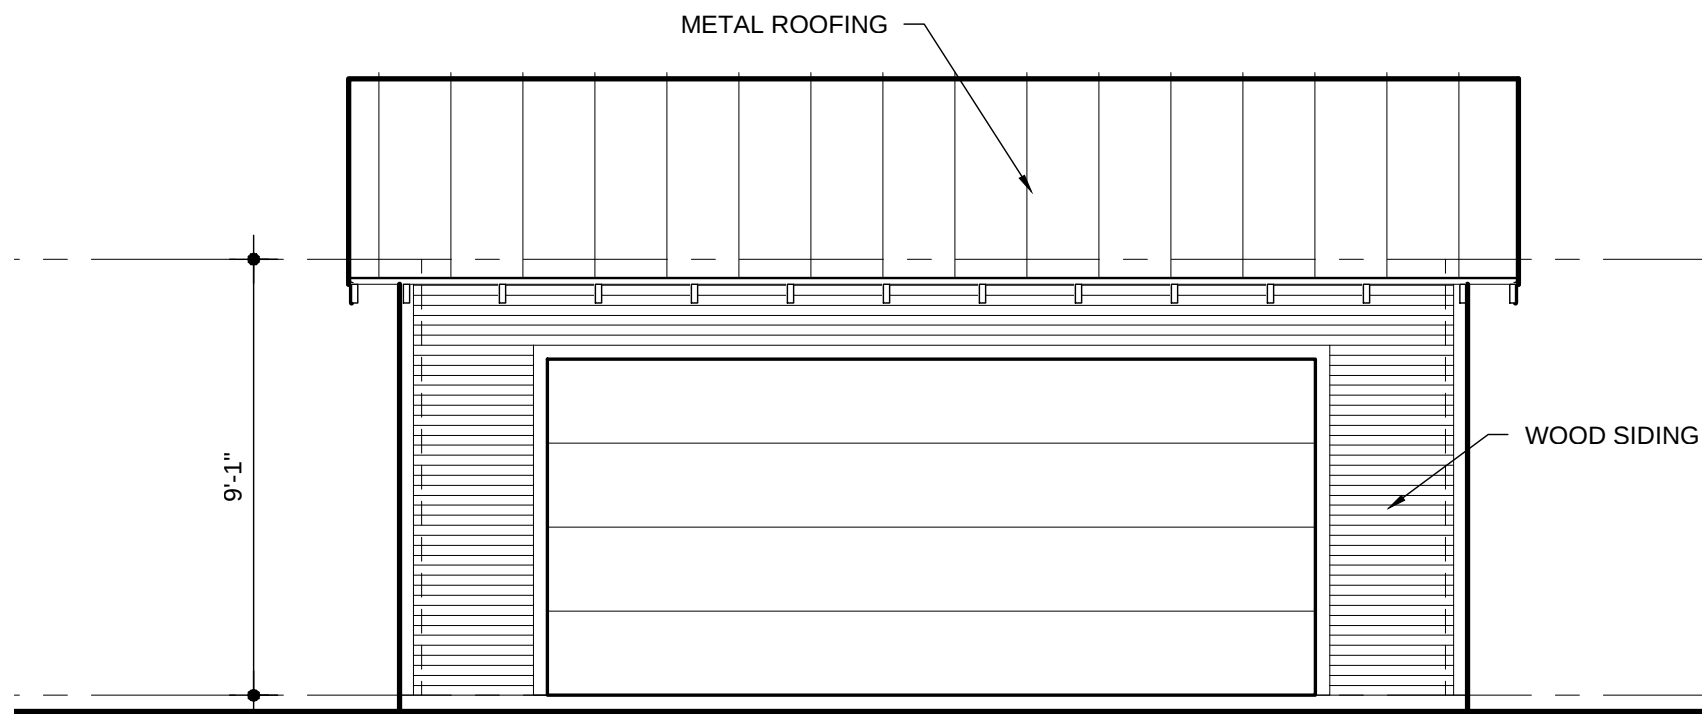


5 GARAGE REAR ELEVATION
A-20 1/4"=1'-0"

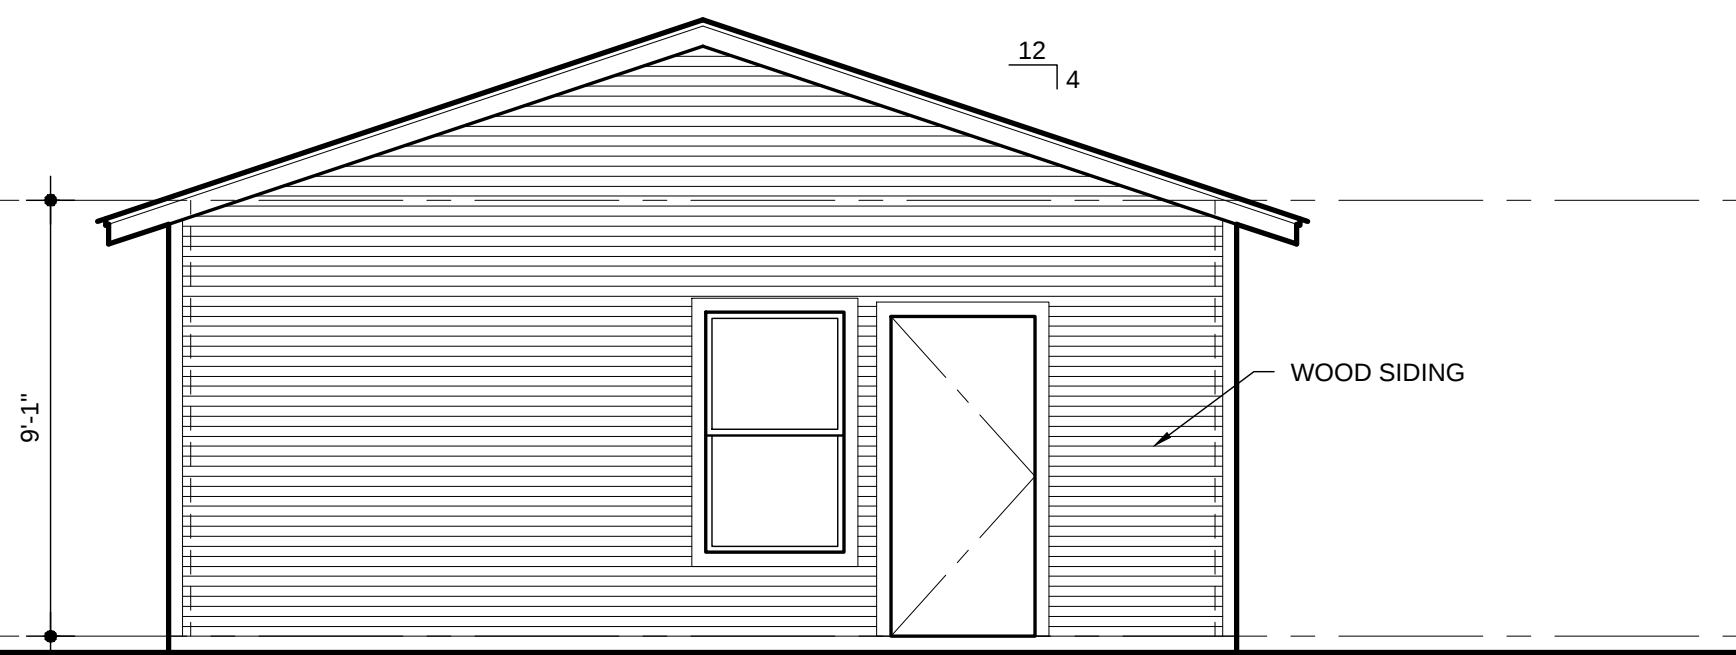


6 GARAGE LEFT ELEVATION
A-20 1/4"=1'-0"

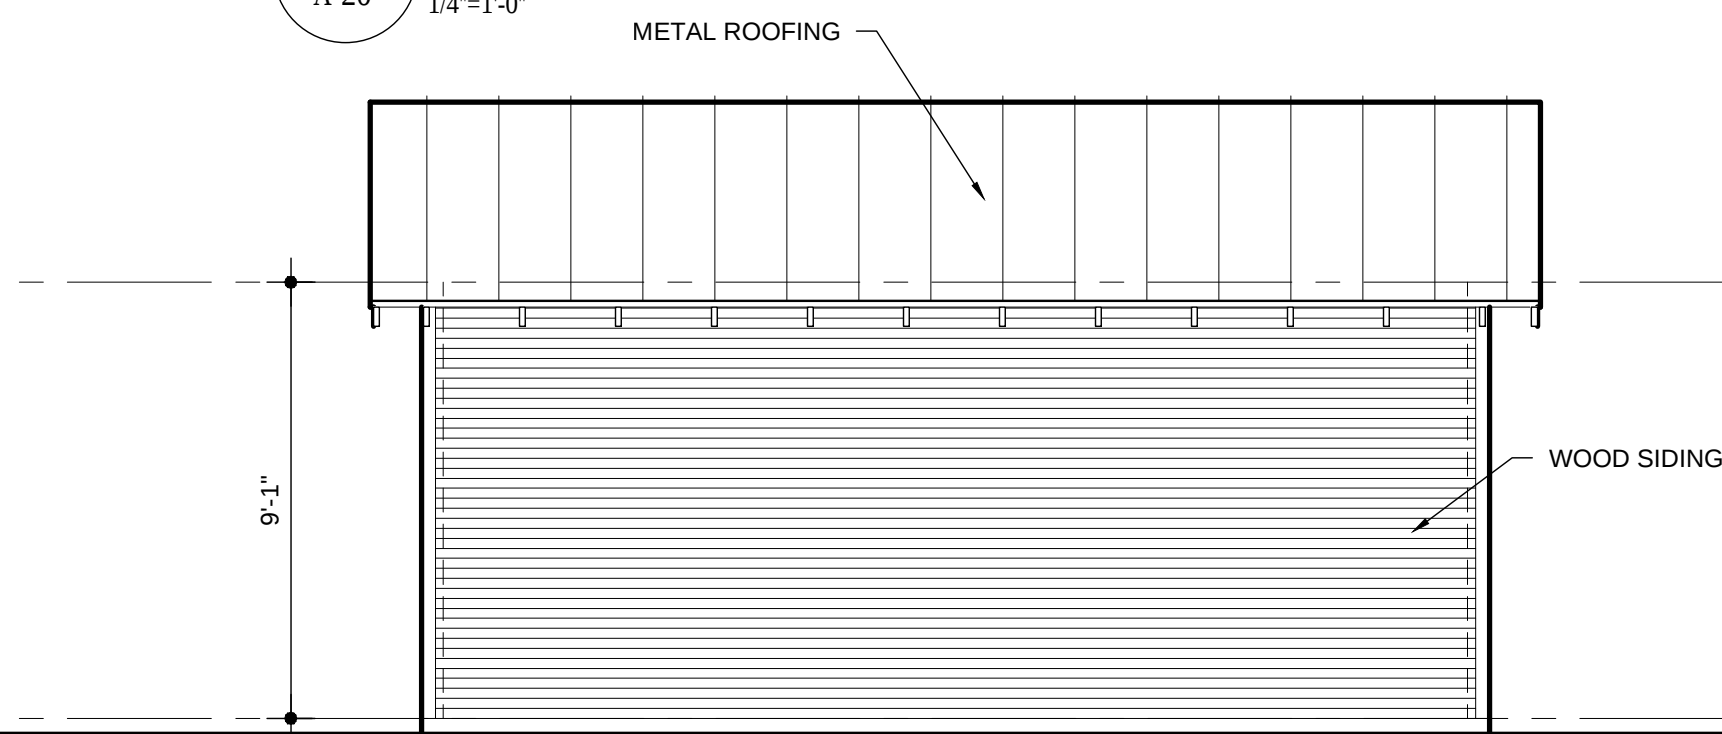

7 GARAGE FRONT ELEVATION
A-20 1/4"=1'-0"

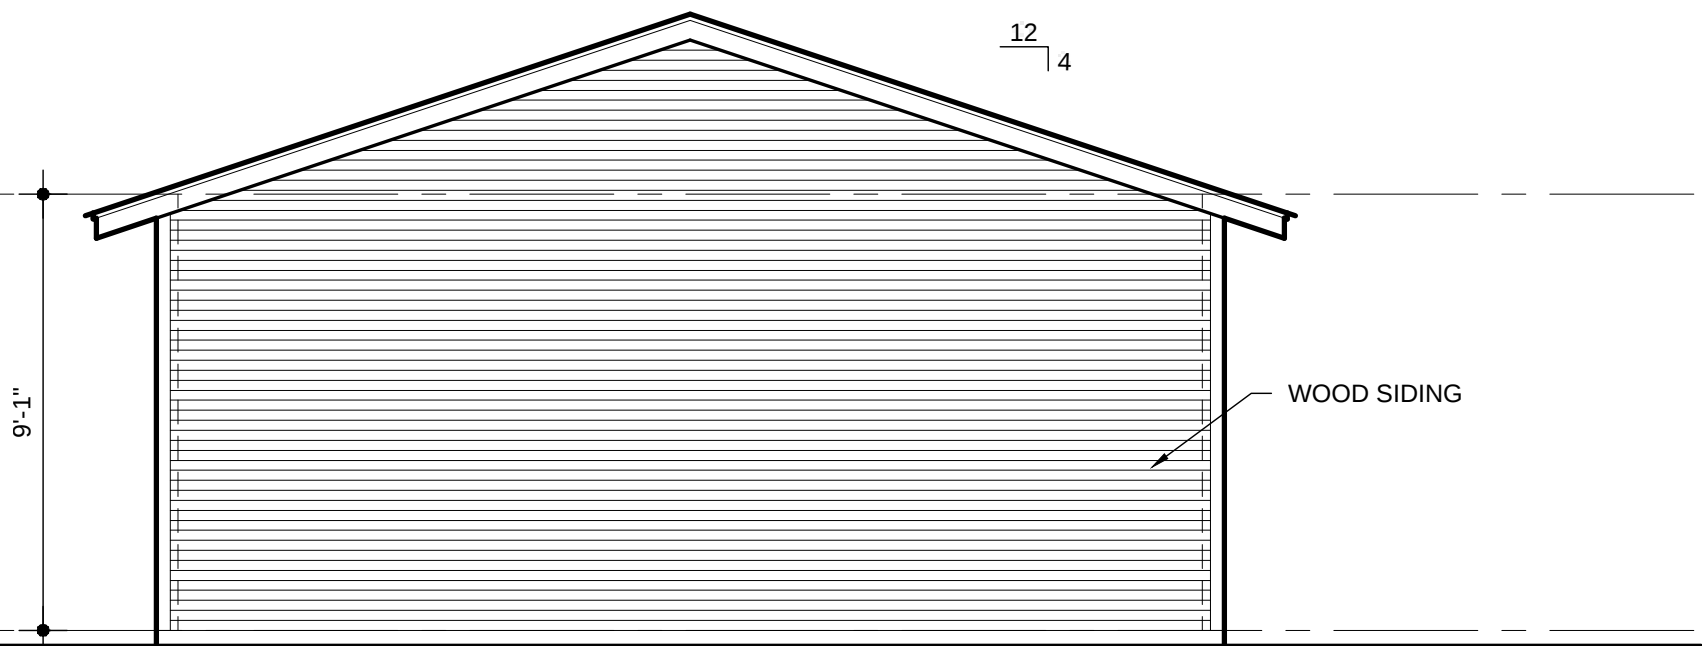

8 GARAGE RIGHT ELEVATION
A-20 1/4"=1'-0"

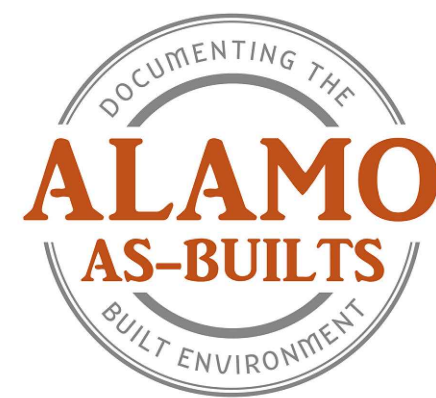

JODY BAKER 210.705.4101
jody@alamoasbuilds.com AlamoAsBuilds.com

574 S. ACADEMY AVE.
NEW BRAUNFELS, TX

EXTERIOR ELEVATIONS

DATE: 07.05.22

AS-BUILTS

Sheet Number

A-20