



The following statement must be included on the site plan:

I, Shawn Beasrook, the Property owner, acknowledge that this site plan submitted for the purposes of rezoning this property is in accordance with all applicable provisions of the zoning ordinance. Additionally, I understand that city council approval of this site plan in conjunction with a rezoning case does not relieve me from adherence to any/all city-adopted codes/ordinances at the time of plan submittal for building permits. Nor does it relieve me from adherence to any/all state or federal rules and regulations.


I, Shawn Beckwith, the Property owner, acknowledge that this site plan submitted for the purposes of rezoning this property is in accordance with all applicable provisions of the zoning ordinance. Additionally, I understand that city council approval of this site plan in conjunction with a rezoning case does not relieve me from adherence to any/all city-adopted codes/ordinances at the time of plan submittal for building permits. Nor does it relieve me from adherence to any/all state or federal rules and regulations.

LEGEND

These standard symbols will be found in the drawing.

- BOUNDARY LINE
- - - - EASEMENT LINE
- - - - BUILDING SETBACK LINE
- CHAINLINK FENCE
- //—// WOOD FENCE
- PLATTED LOT LINE
- ⊙ SET IRON ROD
- CALCULATED POINT
- FOUND IRON ROD
- FENCE POST
- ⊕ WATER METER
- ⊖ ELECTRIC METER
- ⊙ GAS METER
- ⊙ POWER POLE
- (DEED) RECORDED ON DEED
- (F.M.) FIELD MEASURED

GRAPHIC SCALE

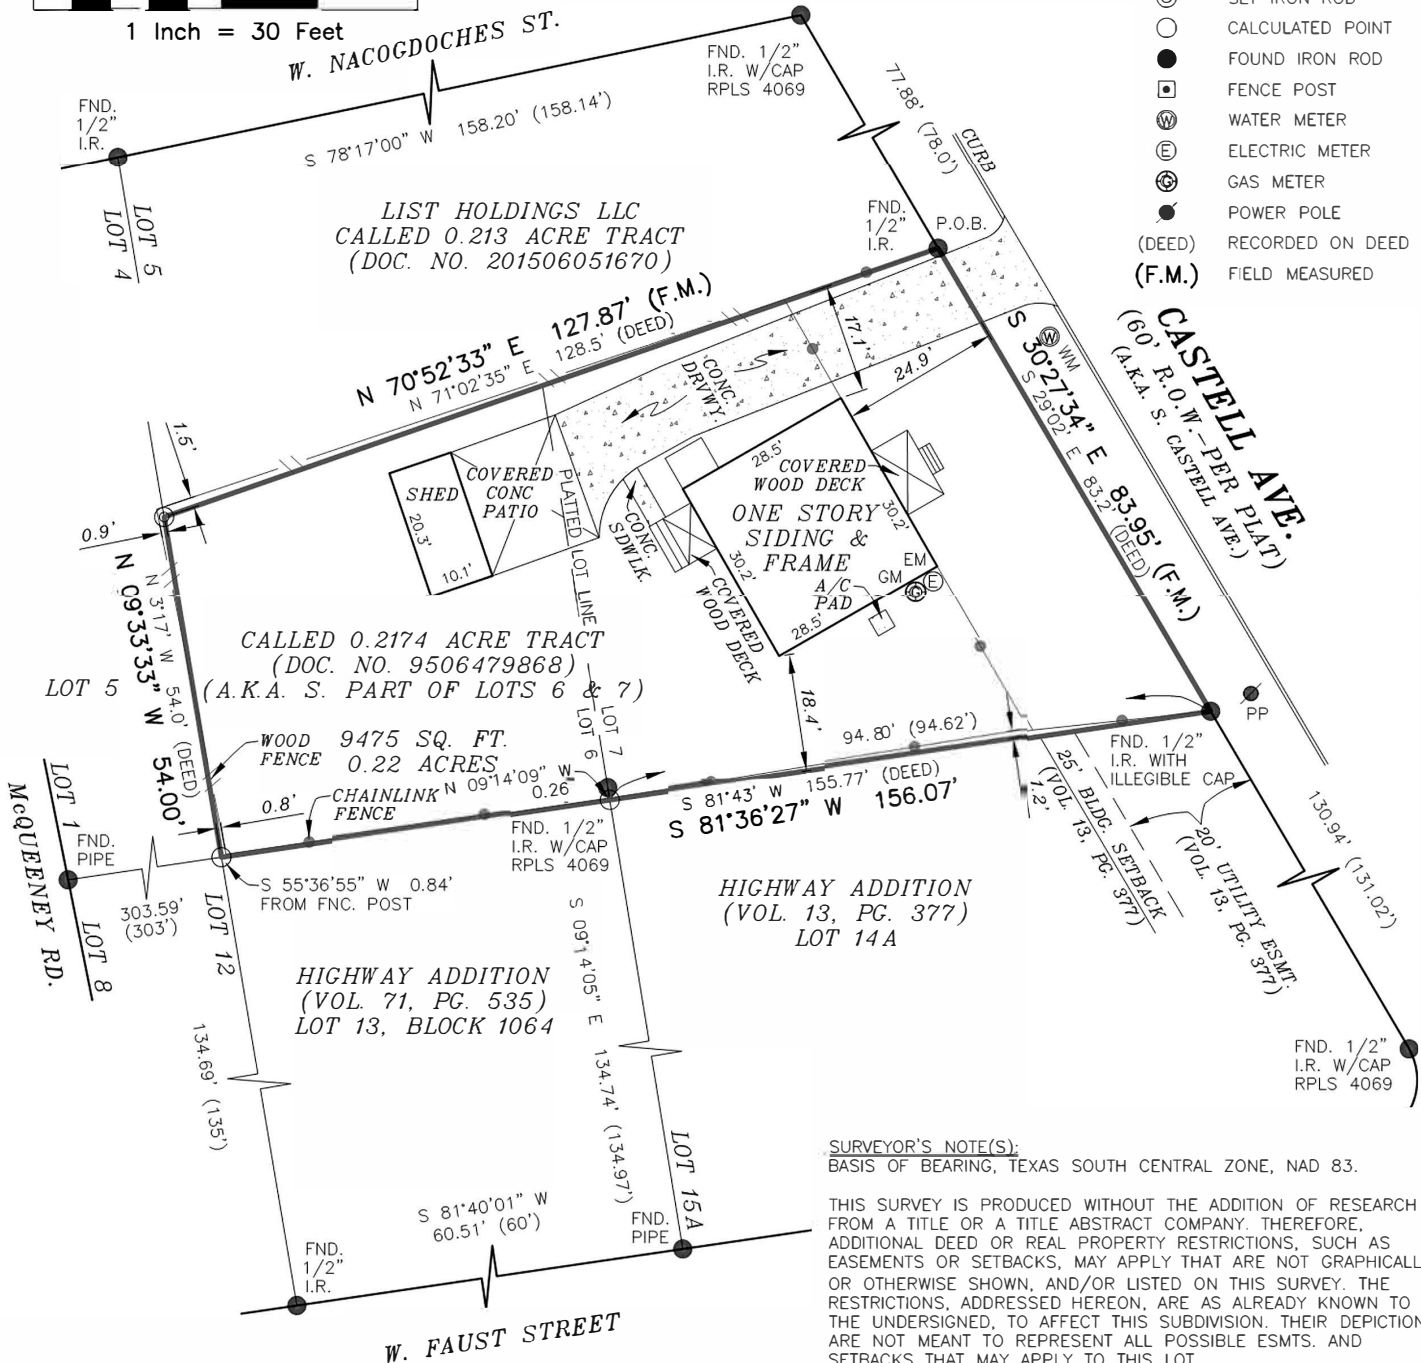

SURVEYOR'S NOTE(S):

BASIS OF BEARING, TEXAS SOUTH CENTRAL ZONE, NAD 83.

THIS SURVEY IS PRODUCED WITHOUT THE ADDITION OF RESEARCH FROM A TITLE OR A TITLE ABSTRACT COMPANY. THEREFORE, ADDITIONAL DEED OR REAL PROPERTY RESTRICTIONS, SUCH AS EASEMENTS OR SETBACKS, MAY APPLY THAT ARE NOT GRAPHICALLY OR OTHERWISE SHOWN, AND/OR LISTED ON THIS SURVEY. THE RESTRICTIONS, ADDRESSED HEREON, ARE AS ALREADY KNOWN TO THE UNDERSIGNED, TO AFFECT THIS SUBDIVISION. THEIR DEPICTIONS ARE NOT MEANT TO REPRESENT ALL POSSIBLE ESMTS. AND SETBACKS THAT MAY APPLY TO THIS LOT.

THE ORIGINAL PLAT RECORD IS ILLEGIBLE. THIS REPRESENTATION IS SURVEYOR'S BEST INTERPRETATION OF RECORD INFORMATION

THE DEEDED BEARINGS AND DISTANCES DOES NOT REPRESENT A MATHEMATICALLY CLOSED FIGURE; THE BOUNDARY, AS DEPICTED HEREON, IS BASED UPON THE MONUMENTATION AS FOUND ON-THE-GROUND, AND THE APPARENT INTENT OF THE SUBD. PLAT.

At date of this survey, the property is in FEMA designated 100 Year ZONE X as verified by FEMA map Panel No: 48091C 0455 E effective date of SEPTEMBER 02, 2009. Exact designations can only be determined by a Elevation Certificate. This information is subject to change as a result of future FEMA map revisions and/or amendments.

I, AARON MICAH REYNOLDS, a Registered Professional Land Surveyor in the State of Texas, do hereby certify to

and that the above map is true and correct according to an actual field survey, made by me on the ground or under my supervision, of the property shown hereon. I further certify that all easements and rights-of-way of which I have been advised are shown hereon and that, except as shown, there are no visible encroachments, no visible overlapping of improvements and no apparent discrepancies or conflicts in the boundary lines, and no visible physical evidence of easements or rights-of-way as of the date of the field survey. I further certify that this survey meets or exceeds the minimum standards established by the Texas Board of Professional Land Surveying (Section 663.18).

Recorded Owner: MELINDA BENBROOK

Address: 930 S. CASTELL AVE. GF No. ---

Legal Description of the Land: All that certain tract or parcel of land lying and being situated within the corporate limits of the City of New Braunfels, Comal County, Texas, being known and designated as the South part of Lots 6 and 7, New City Block 1064, HIGHWAY ADDITION, according to plat recorded in Volume 71, Page 535, Deed Records, Comal County, Texas

SUBJECT TO RESTRICTIVE COVENANTS AND/OR EASEMENTS RECORDED IN VOLUME 71, PAGE 535, DEED RECORDS, COMAL COUNTY, TEXAS

PROPERTY PHOTOGRAPH:



FINAL "AS-BUILT" SURVEY

JOB NO.:	2112085267	NO.	REVISION	DATE
DATE:	12/17/21			
DRAWN BY:	JD/AMV			
APPROVED BY:	AMR			



Aaron M. Reynolds
AARON MICAH REYNOLDS, R.P.L.S.
 Registered Professional Land Surveyor
 Registration No. 6644



P.O. BOX 160369
 SAN ANTONIO, TEXAS 78280
 PHONE: (210) 572-1995
 WEB: WWW.AMERISURVEYORS.COM